


DRAWING NUMBER  
A-105  
CANTOR FITZGERALD  
91051


DRAWING NUMBER  
A-105  
CANTOR FITZGERALD  
91051

DRAWING NUMBER  
A-105  
CANTOR FITZGERALD  
91051


DRAWING NUMBER  
A-105  
CANTOR FITZGERALD  
91051

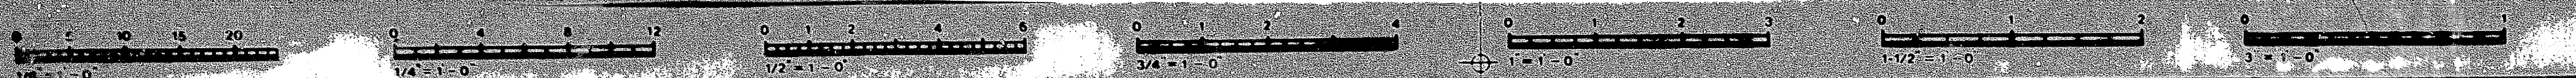


IF THIS DRAWING IS NOT 24\"/>

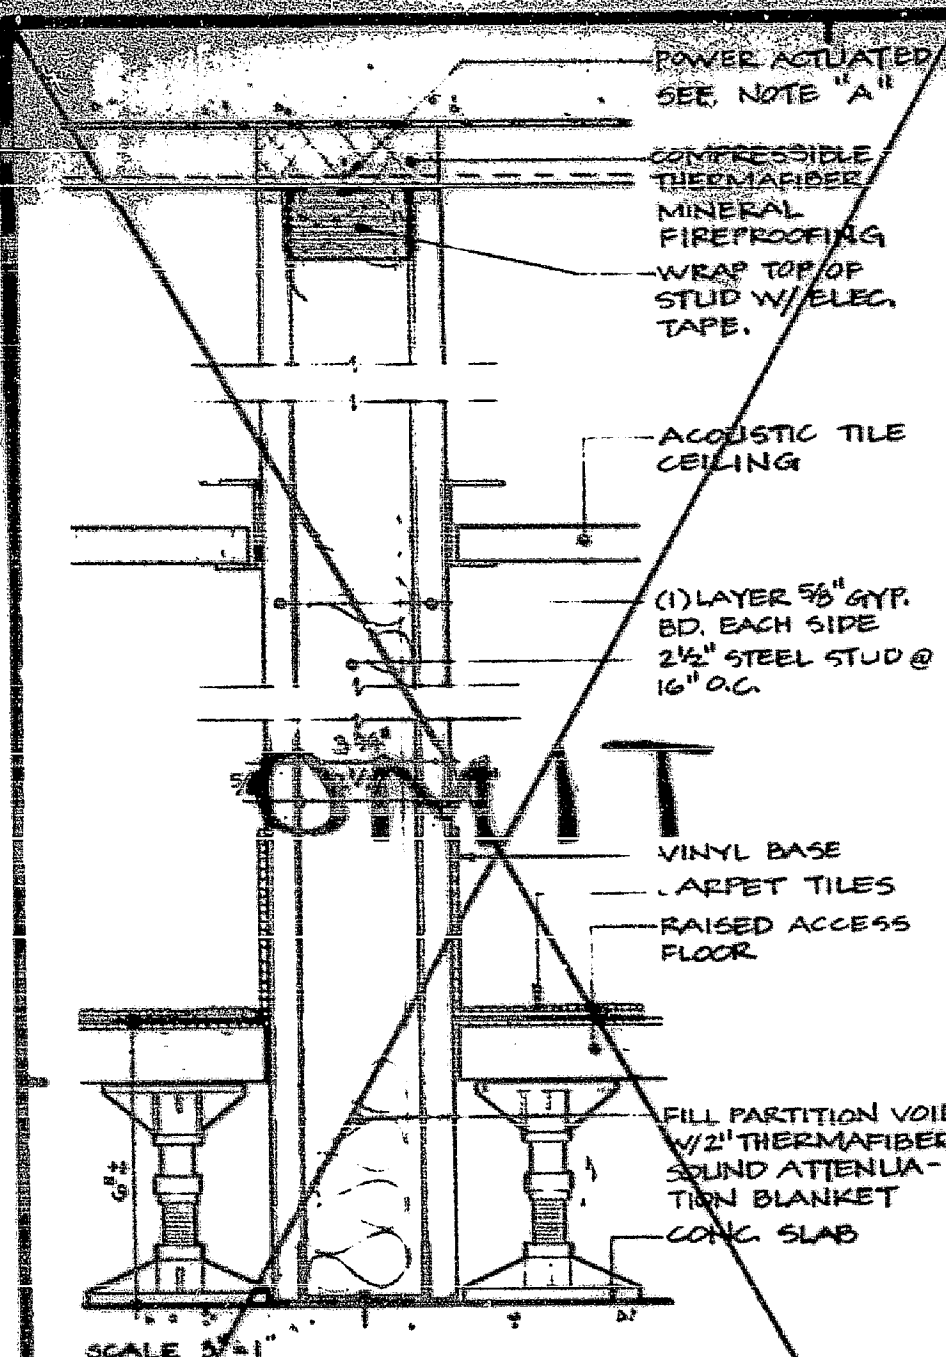


1 NON FIRE RATED PARTITION W/ ACOUSTICAL INSULATION SIMILAR TO WTC TYPE 15

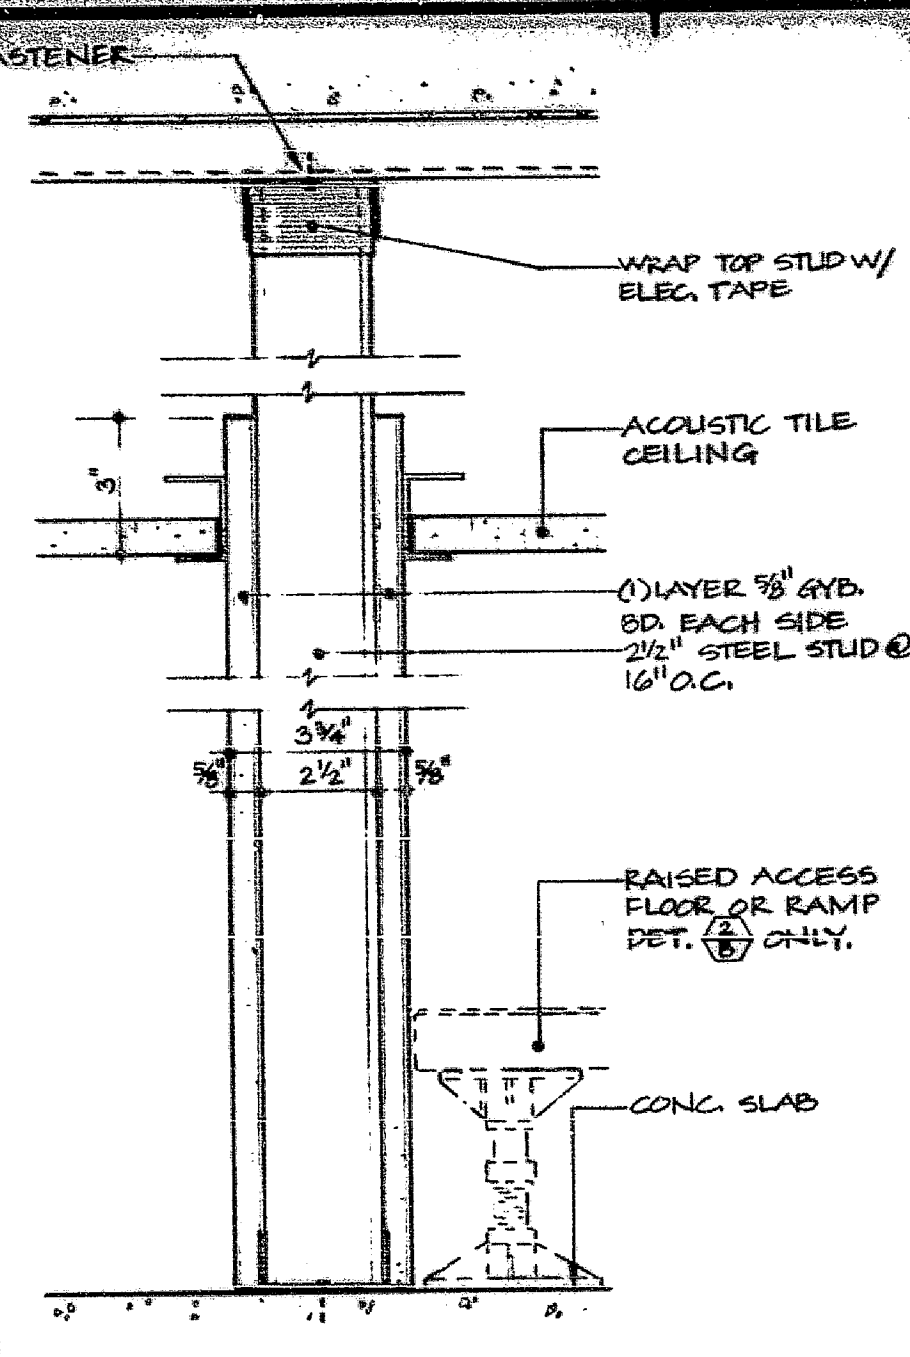


2 NON FIRE RATED PARTITION SIMILAR TO WTC TYPE 14

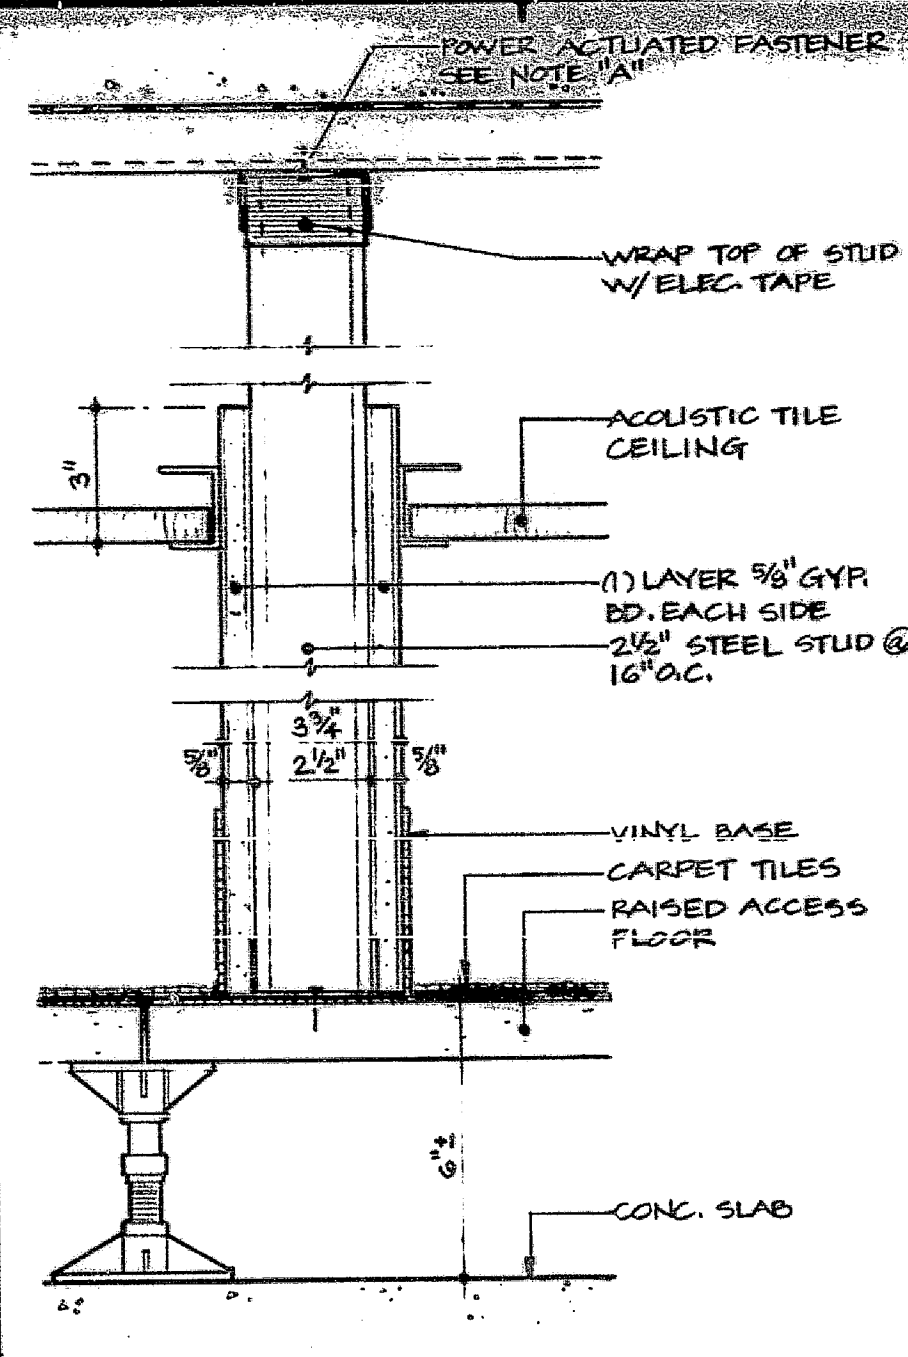

3 NON FIRE RATED PARTITION SIMILAR TO WTC TYPE 14

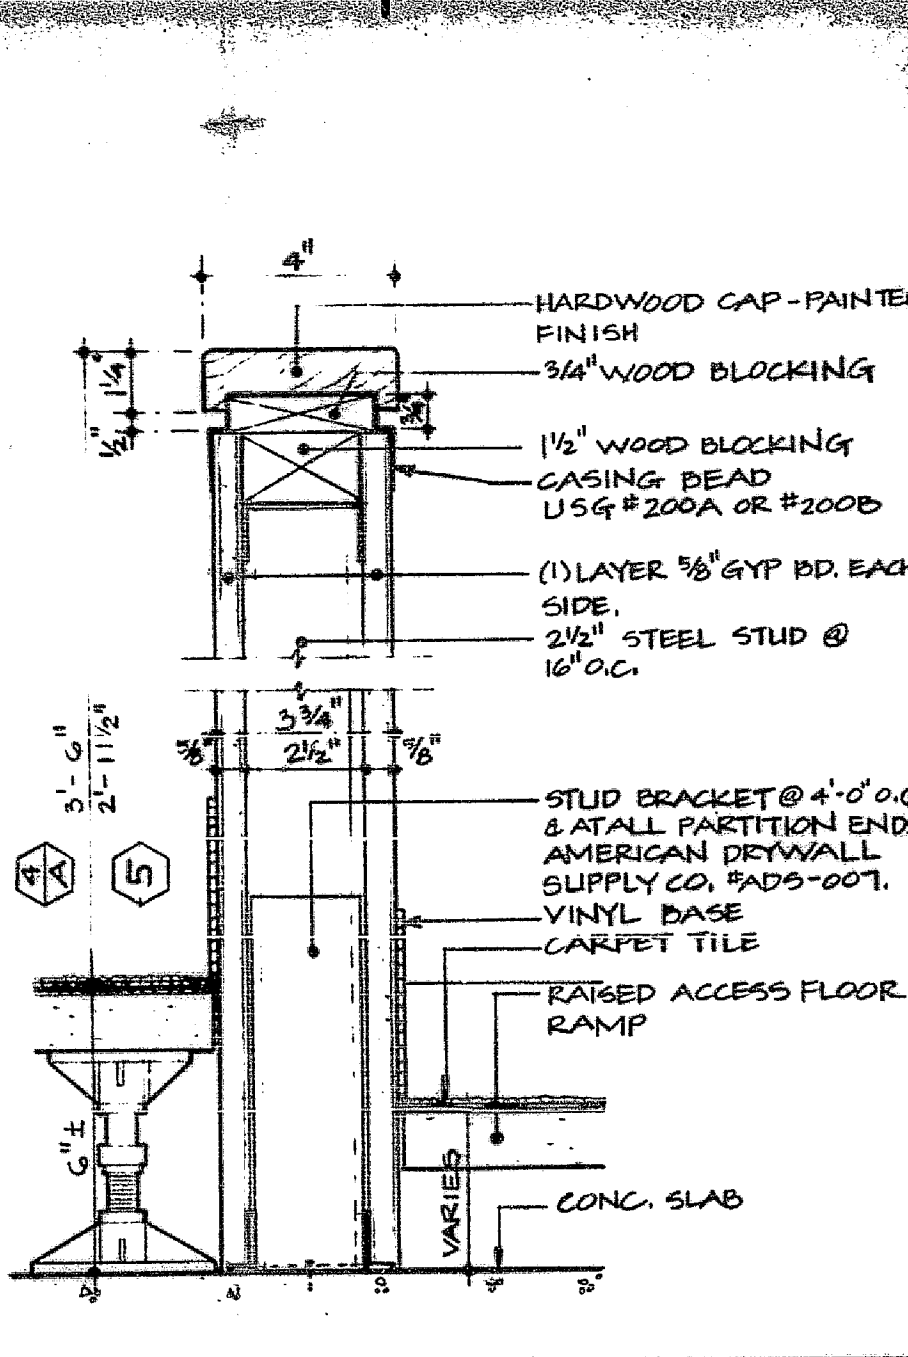


4A LOW PARTITION FASTENED TO CONCRETE SLAB

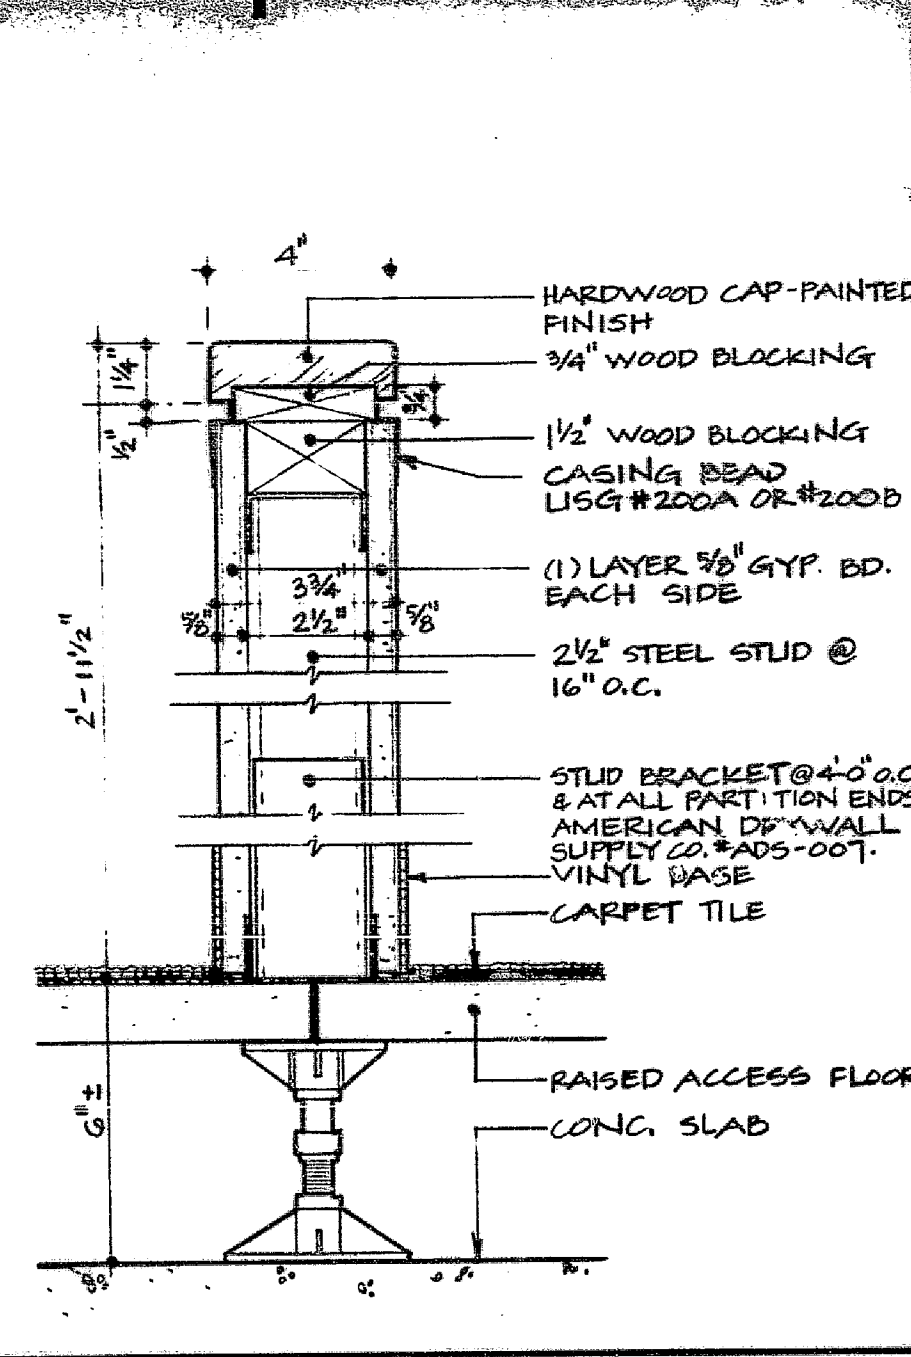


5B LOW PARTITION FASTENED TO RAISED ACCESS FLOOR


NOTE "A"  
POWER ACTUATED FASTENERS SHALL BE HILTI, TYPE NO. 3305224, FINISH 3302A, SHANK DIAMETER 0.145\"/>

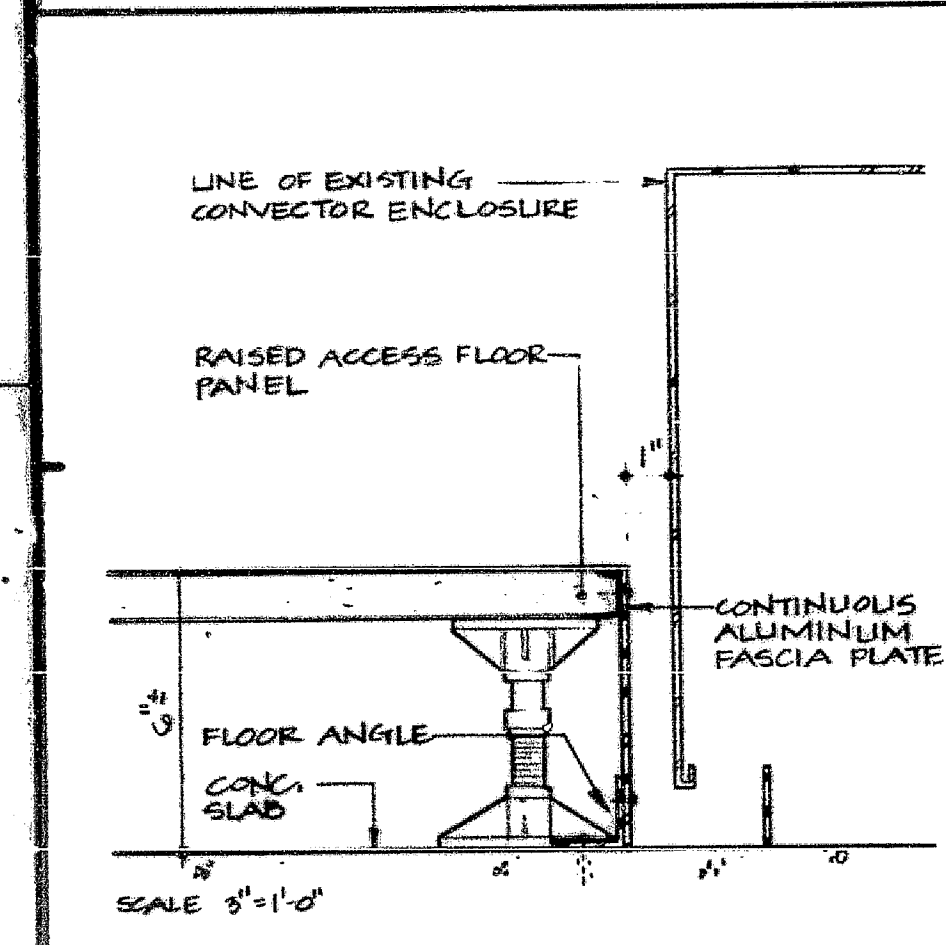


1 RAISED FLOOR AT CONVECTOR

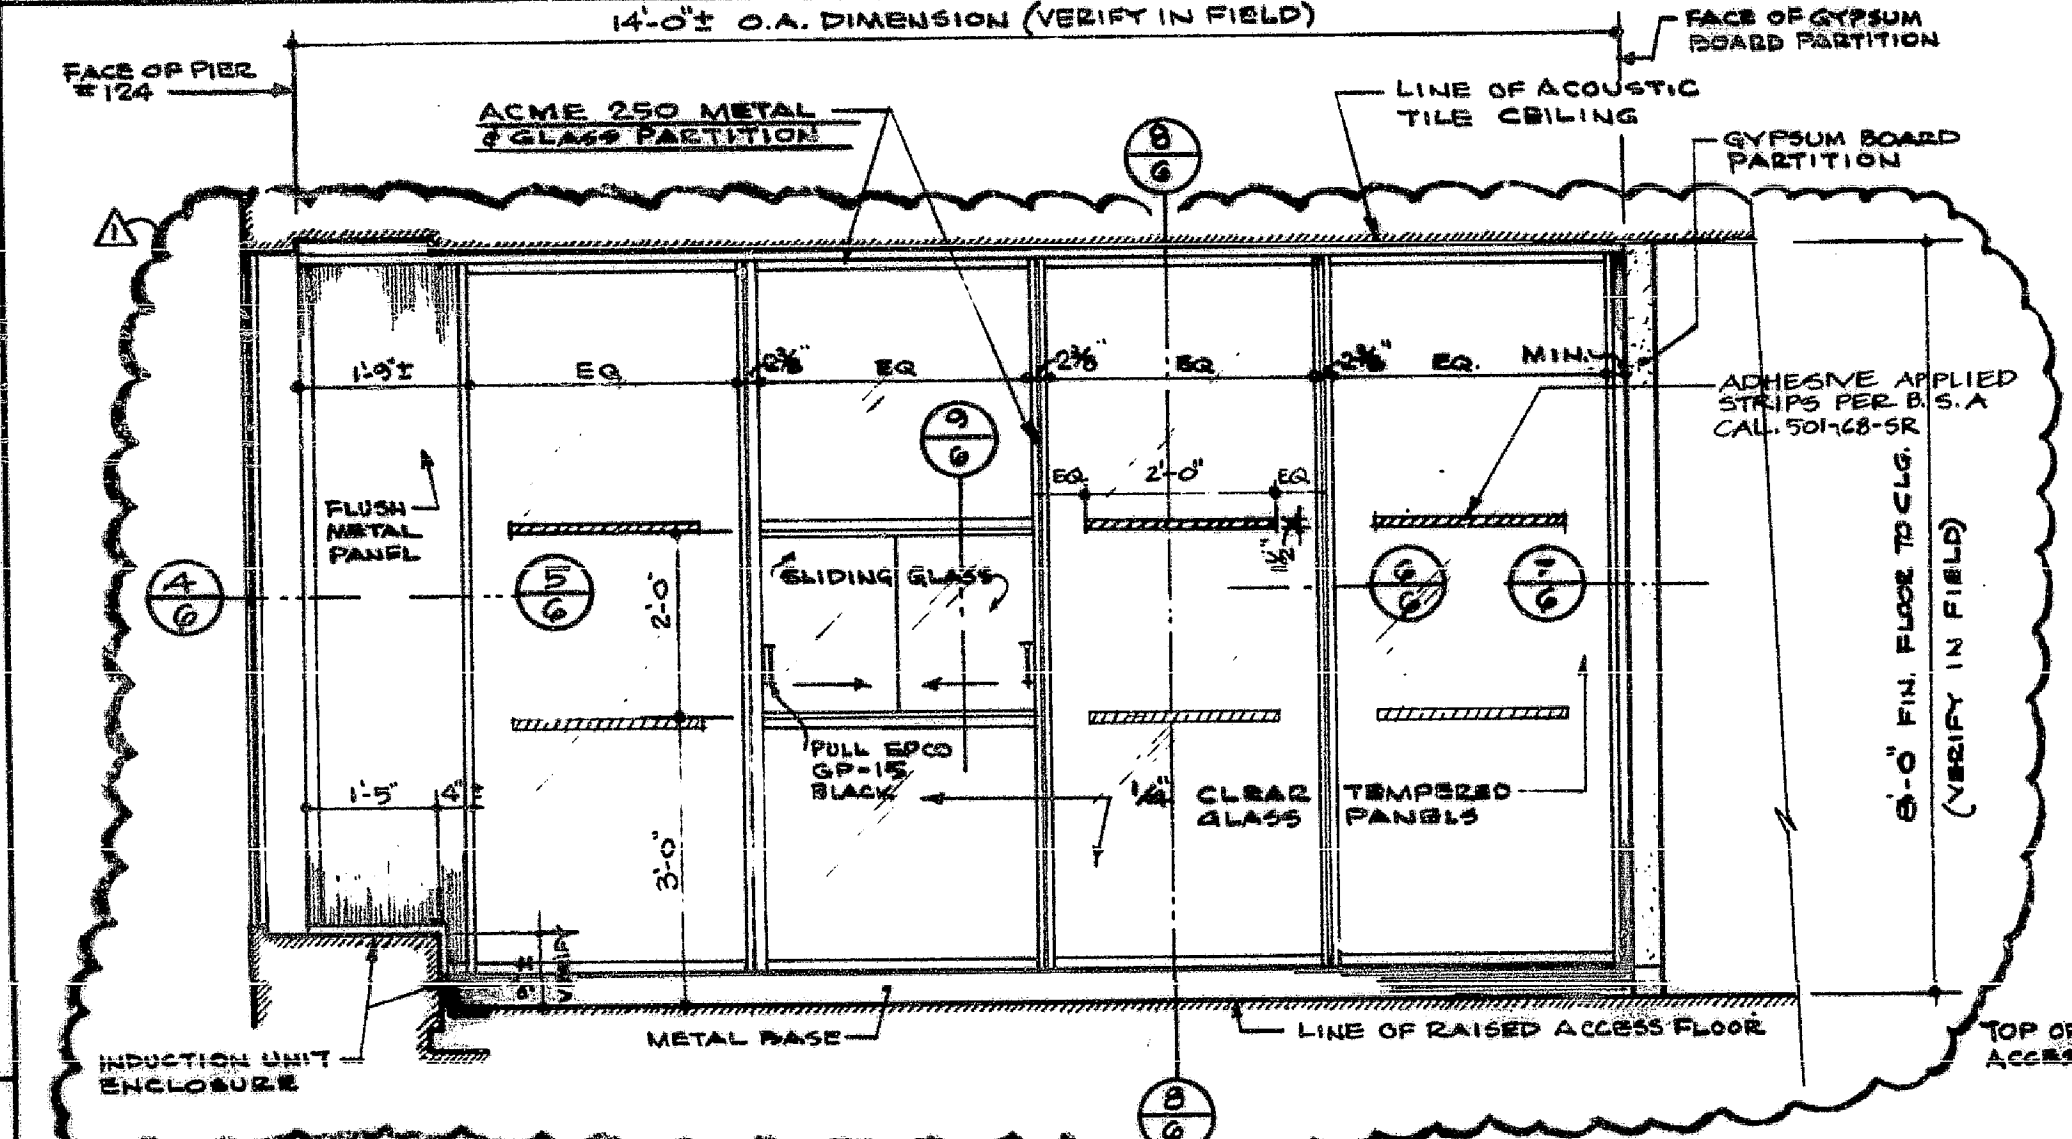


3 PART ELEVATION EAST WALL SPACE NO. 8 @ 1/2\"/>

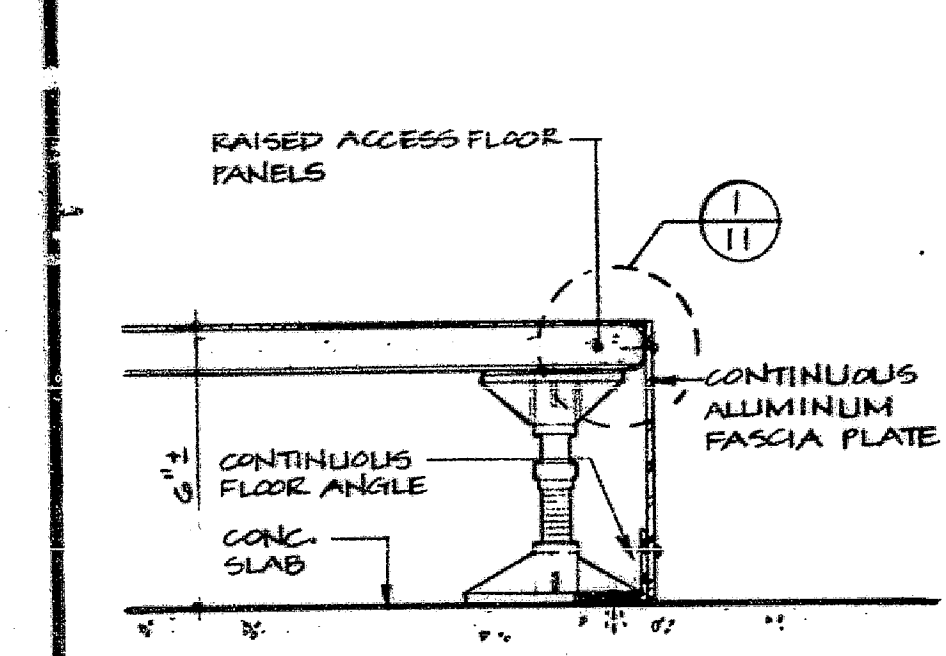


2 RAISED FLOOR AT TRADING DESK WELL

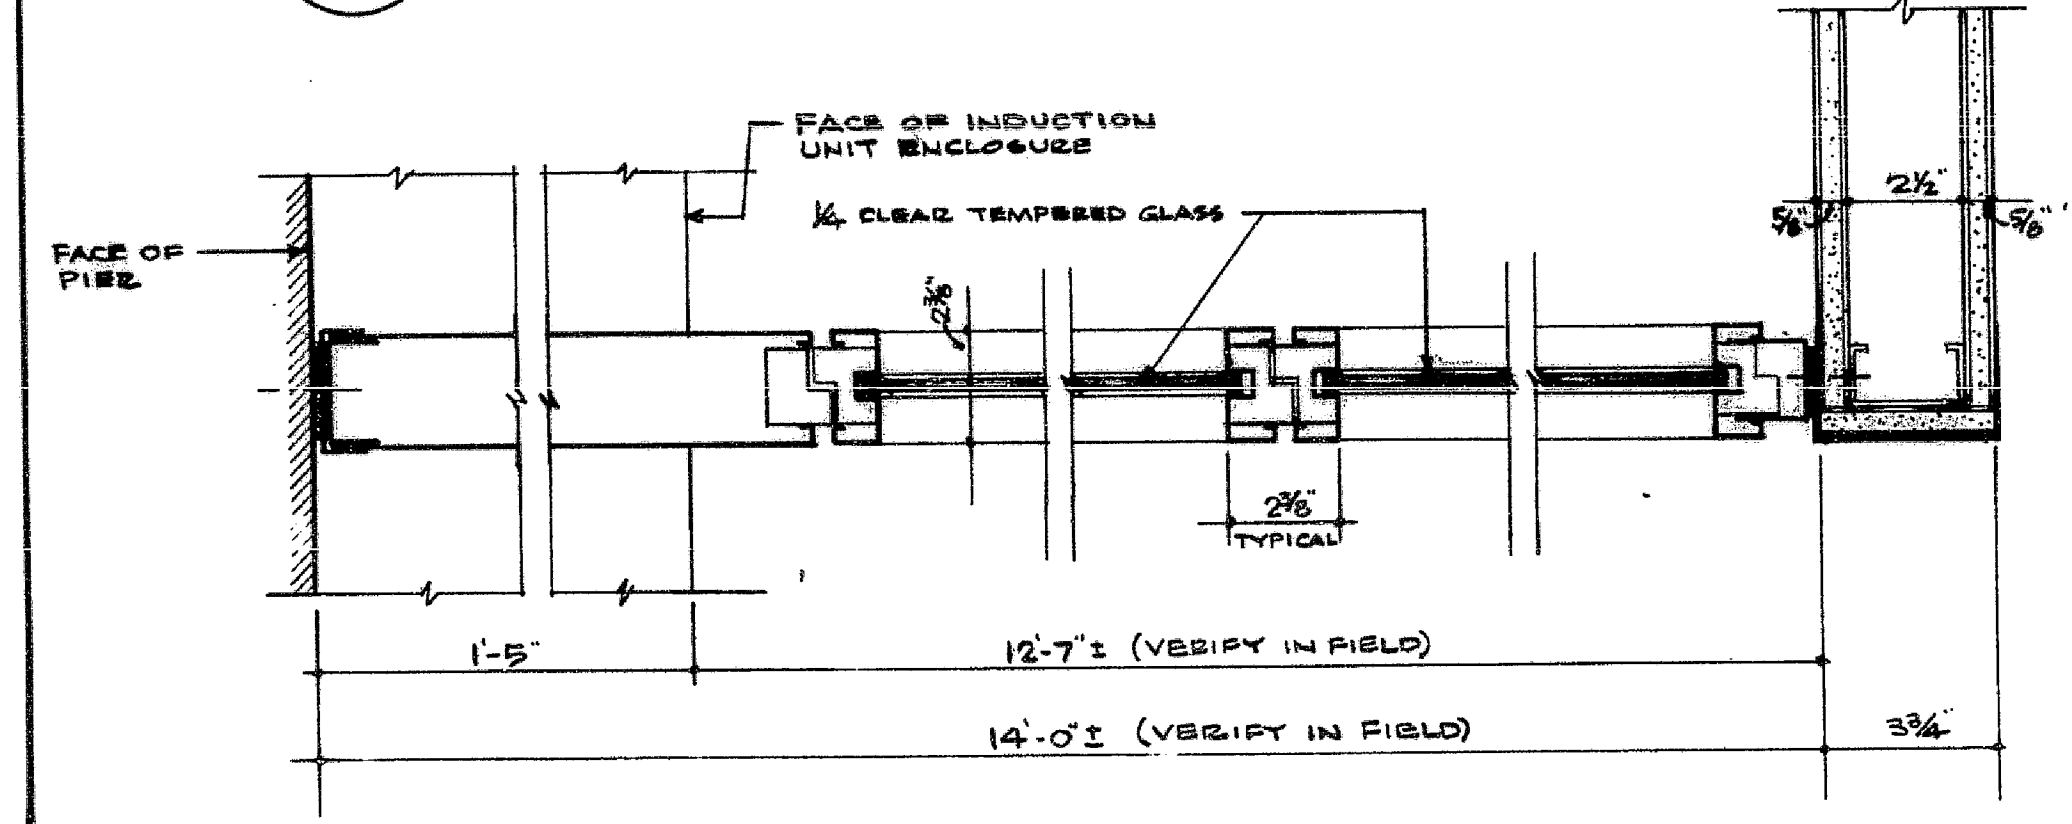


6 FULL HEIGHT METAL & GLASS PARTITION WTC TYPE 8 (ACME NO. 250)

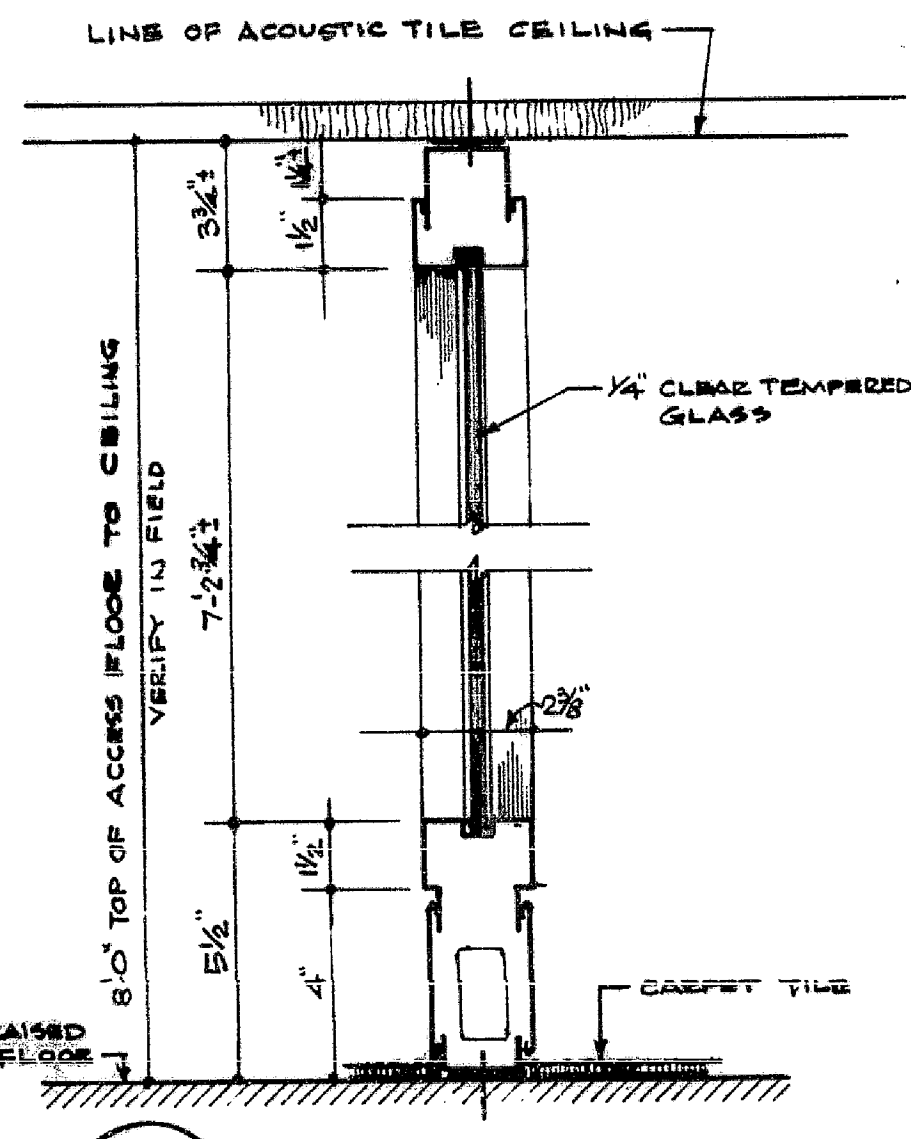


8 VERTICAL SECTION @ 3\"/>

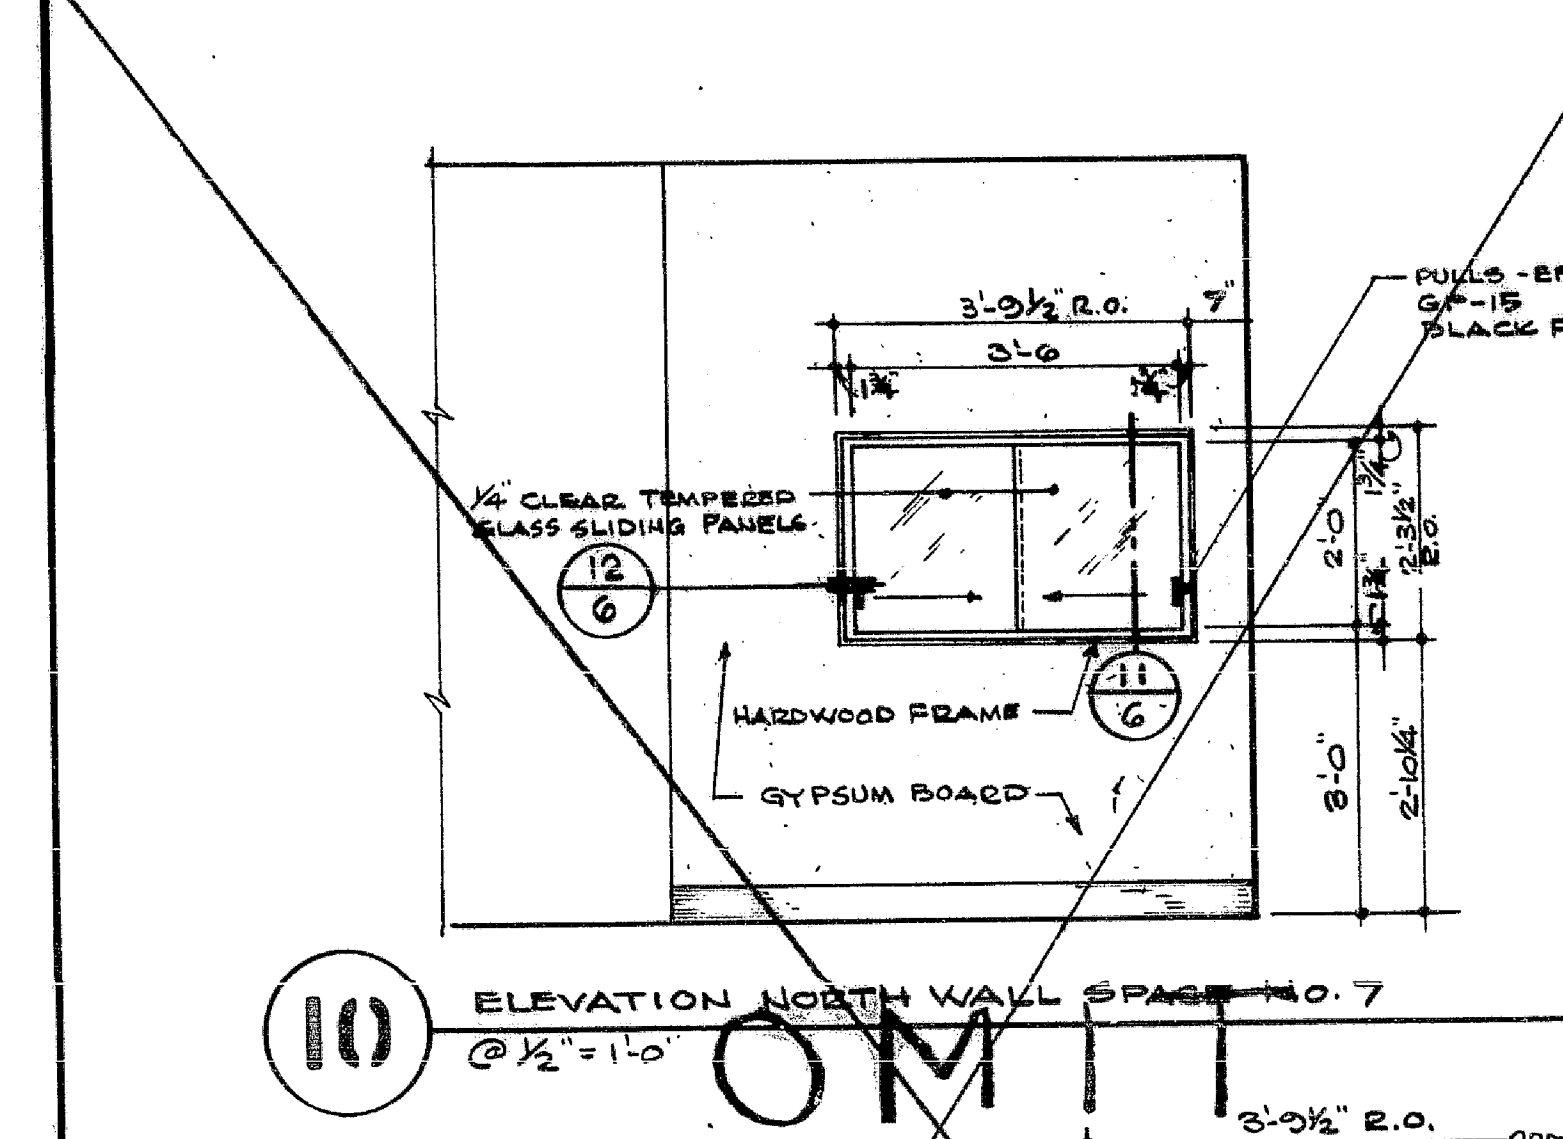

10 ELEVATION NORTH WALL SPACE NO. 7 @ 1/2\"/>

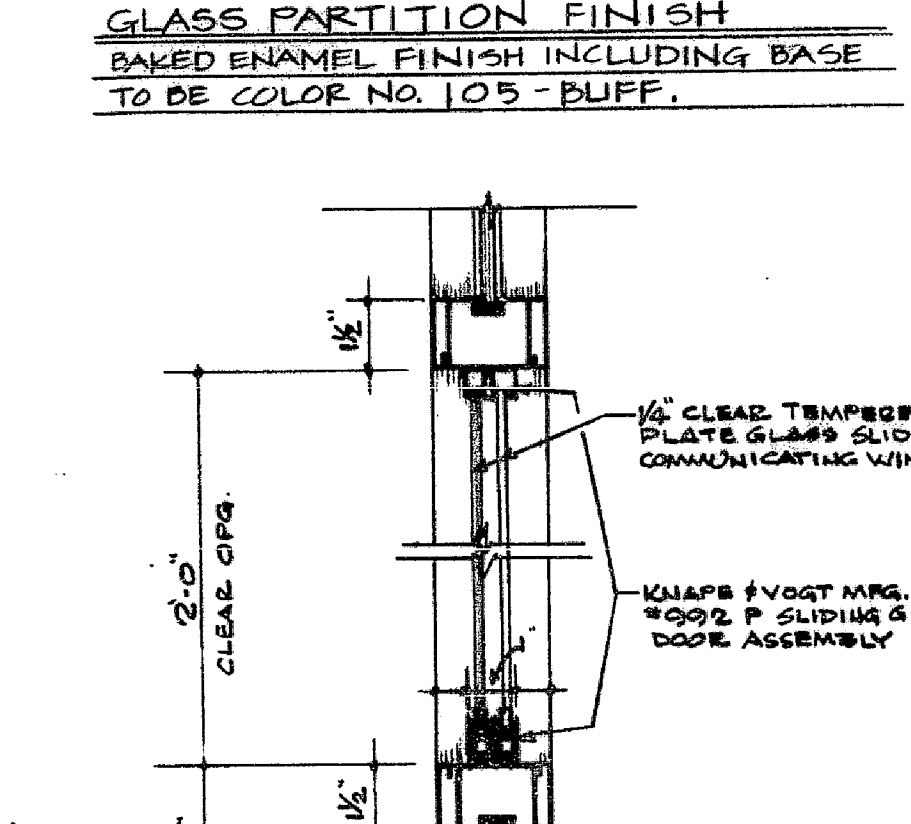

9 VERTICAL SECTION @ SLIDING WINDOW @ 3\"/>

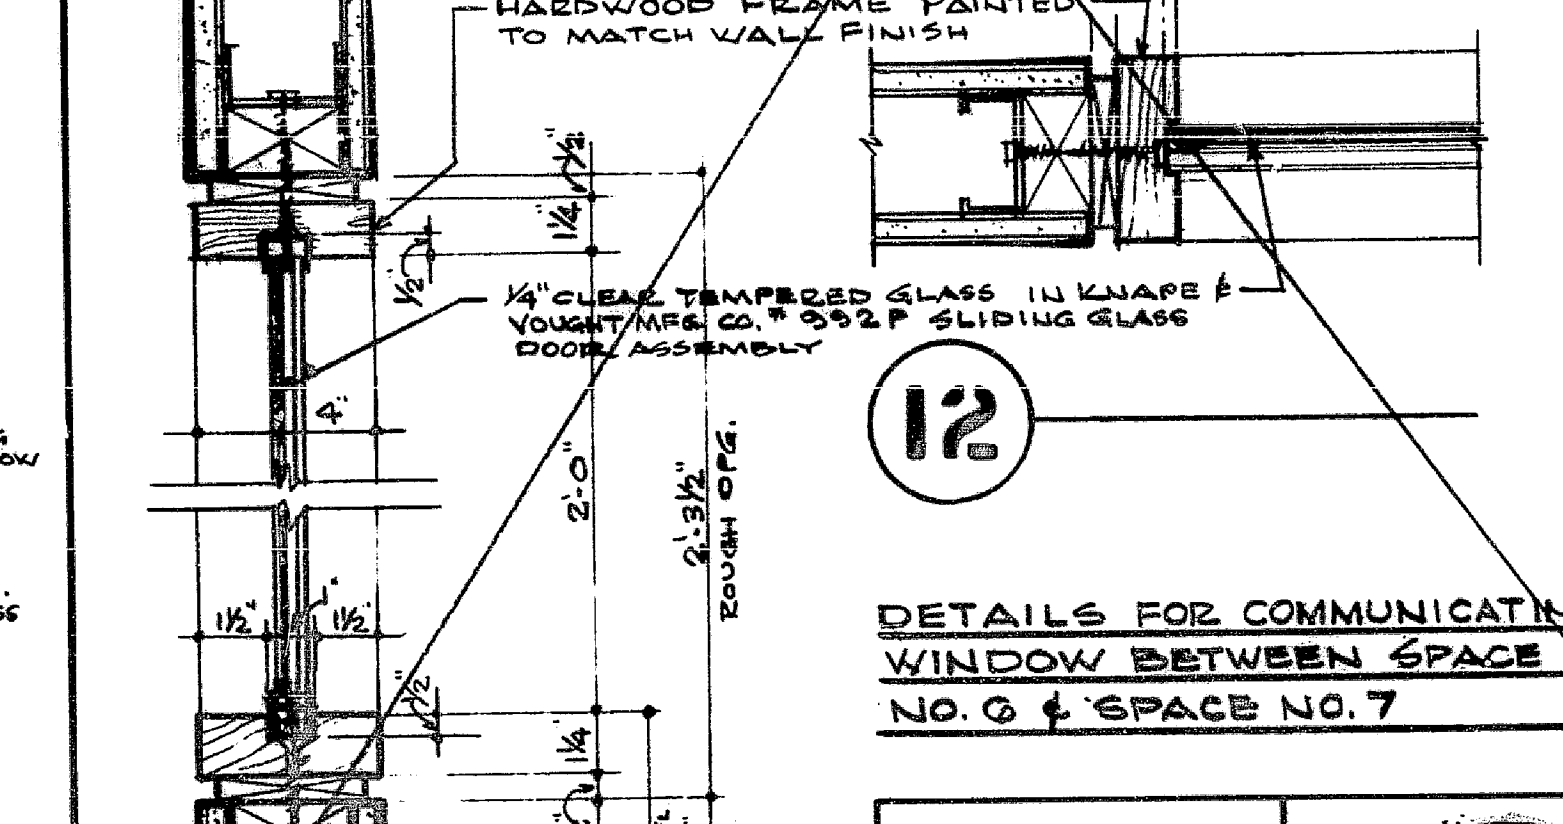

11 DETAILS FOR COMMUNICATING WINDOW BETWEEN SPACE NO. 6 & SPACE NO. 7

JUSTIN PC ARCHITECTS  
205 LEXINGTON AVE  
NEW YORK NY 10016  
TEL (212) 689 9550

JOHN C. WESTRICK & ASSOCIATES  
CONSULTING ENGINEERS  
2110 MAPLE AVE. SOUTH PLAINFIELD, N.J. 07080  
201 581-4170

DATE	ISSUED TO	PR.	TH.
3/22/91	PORT AUTHORITY FOR APPROVAL	10	1
3/22/91	CFSC FOR RECORD	6	4
4/10/91	CONTRACTORS FOR BIDDING	1	1
5-3-91	CFSC	1	1
5-3-91	P.A. FOR APPROVAL	10	-
5-22-91	CD6 MESTAL	5	1
6-7-90	CFSC	1	-
10-21-91	P.A. "AS BUILT DRAWING"	-	1

AS BUILT DRAWING  
Signature: [Signature]  
Date: 8-6-91  
JUSTIN PC ARCHITECTS

NO.	DATE	REVISION	BY
1	4-18-91	REVISED PER PORT AUTHORITY COMMENTS	T.L.

CANTOR, FITZGERALD SECURITIES CORP.  
105th FLOOR  
ONE WORLD TRADECENTER, NEW YORK, N.Y.

PROPOSED NEW TRADING ROOM FOR INVESTMENT STRATEGIES  
PARTITION & RAISED FLOOR DETAILS

PROJECT NO. 106  
SCALE AS NOTED  
DRAWN BY T.L.  
CHECKED BY J.F.P.  
DATE MARCH 20, 1991

DRAWING NO. 105P  
PHASE P  
T.A.A. NO. W91051